

N7007012 - Recent revisions

Rev.	Comment	Date	Drawn	Appr.

Gas Note:
 All gas mains and ducts that contain a gas main must be overlaid with a yellow line. All gas mains and ducts that do not contain a gas main must be overlaid with a red line.

Maximum Proximity to Properties

Maximum Building Proximity (m)	1.5 bar	2 bar	2.5 bar	3 bar
Up to 125	2	4	4	6
125 to 250	2	4	4	6
250 to 500	1	2	4	8
500 to 1000	1	5	13	15

Ducting Specification

- Ducting for mains must be yellow and non-perforated and only used perpendicular to the main.
- Ducting for services must be yellow and perforated along its entire length.
- Only one pipe is allowed per duct.

Gas Pipe External Diameter	Duct Inside Diameter
25mm & 32mm	40mm
40mm	100mm
50mm	150mm
75mm	200mm
100mm	300mm
150mm & 200mm	400mm

Marker Positions

- For all marker types any position where damage could occur, especially from vehicles, shall be avoided.
- Some concealed (vertical) meter boxes shall not:
- Be a trip hazard
- Be a fire hazard

Excavation Carried Out by BUUK
 All excavations shall be excavated and reinstated by the contractor. The reinstatement shall be to the satisfaction of the other interested parties. It will be the responsibility of the customer.

Plan Notes

- Proposed
- Lead
- 100mm MP PE80
- 25mm LP PE80
- 50mm LP PE80
- 75mm LP PE80
- 100mm LP PE80
- 150mm LP PE80
- 200mm LP PE80
- 250mm LP PE80
- 300mm LP PE80
- 400mm LP PE80














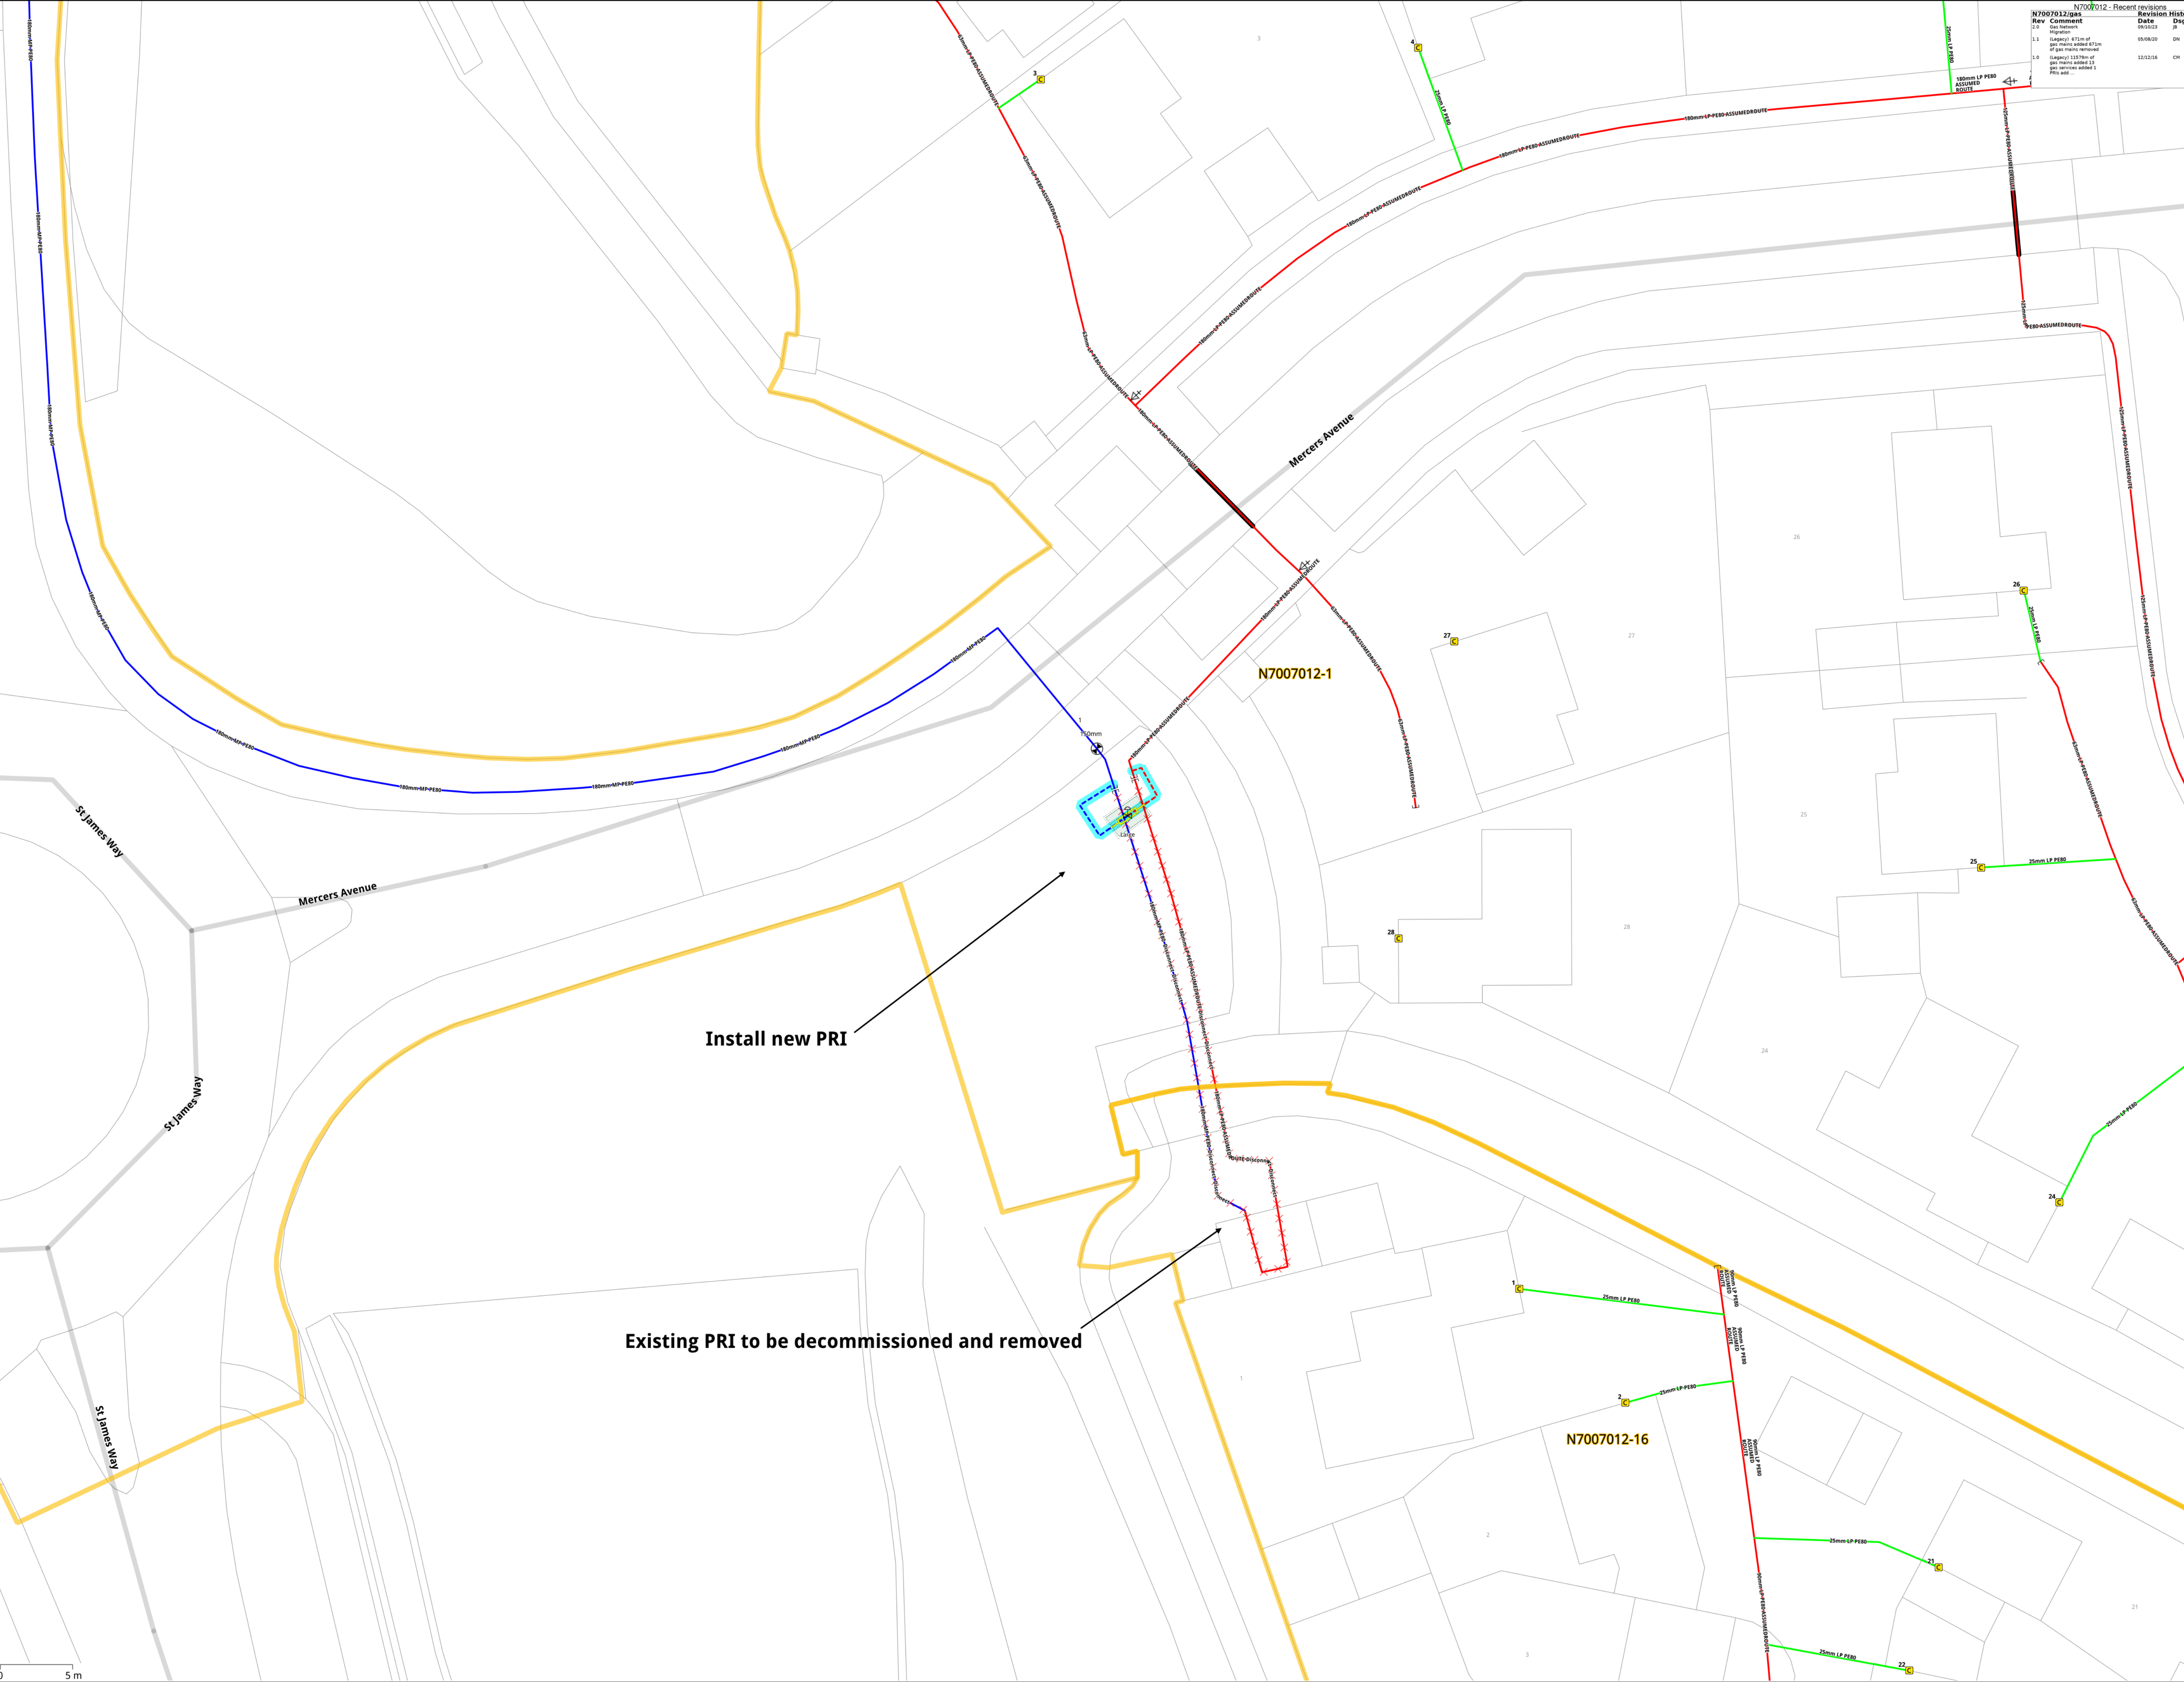

0 5m

gtec

GTC, Hivight Business Park, Lutterworth, Leics, LE15 9JF
 Tel: 01535 240393
 www.gtc-uk.co.uk

Last Edit By: [Signature]
 Last Approved By: jamiebuckle 09102023

OS Ref: 546876,219864
 Location: St Michaels Mead

Developer/Client: Countryside Properties plc
 Drawing Number/Title: 16f2ec3-0502-474b-b8b7-66af22a99a2a
 Network Number: N7007012
 Project Number: N7007012-1
 Scale: 1:200
 Sheet Size: A1
 Revision: 2.0